

RESIDENCE FOR MR. CARL ADAMS



OAKLEY & OAKLEY
ARCHITECTS & ENGINEERS
7700 EDGEWATER DRIVE, STE. 615
OAKLAND, CA 94621
510.562.6028
FAX 510.562.6043

STRUCTURAL ENGINEERS:
OAKLEY & OAKLEY
7700 EDGEWATER DRIVE, SUITE 615
OAKLAND, CA 94621
Phone: 510-562-6028
Fax: 510-562-6043


CALIFORNIA GREEN CONSULTANT:
HASFRA BURT, AIA
2511 CASTRO VALLEY BLVD., SUITE 109
CASTRO VALLEY, CA 94546
510-830-4794



OWNER:
R. CARL ADAMS
333 JERILYNN AVENUE
RICHMOND, CA 94806

AS BUILT RETAINING WALL DETAILS

Object number	2013-63
Date	1/17/2014
Borrowed by	STAFF
Checked by	J.O
S2/2	
Initials	AS NOTED

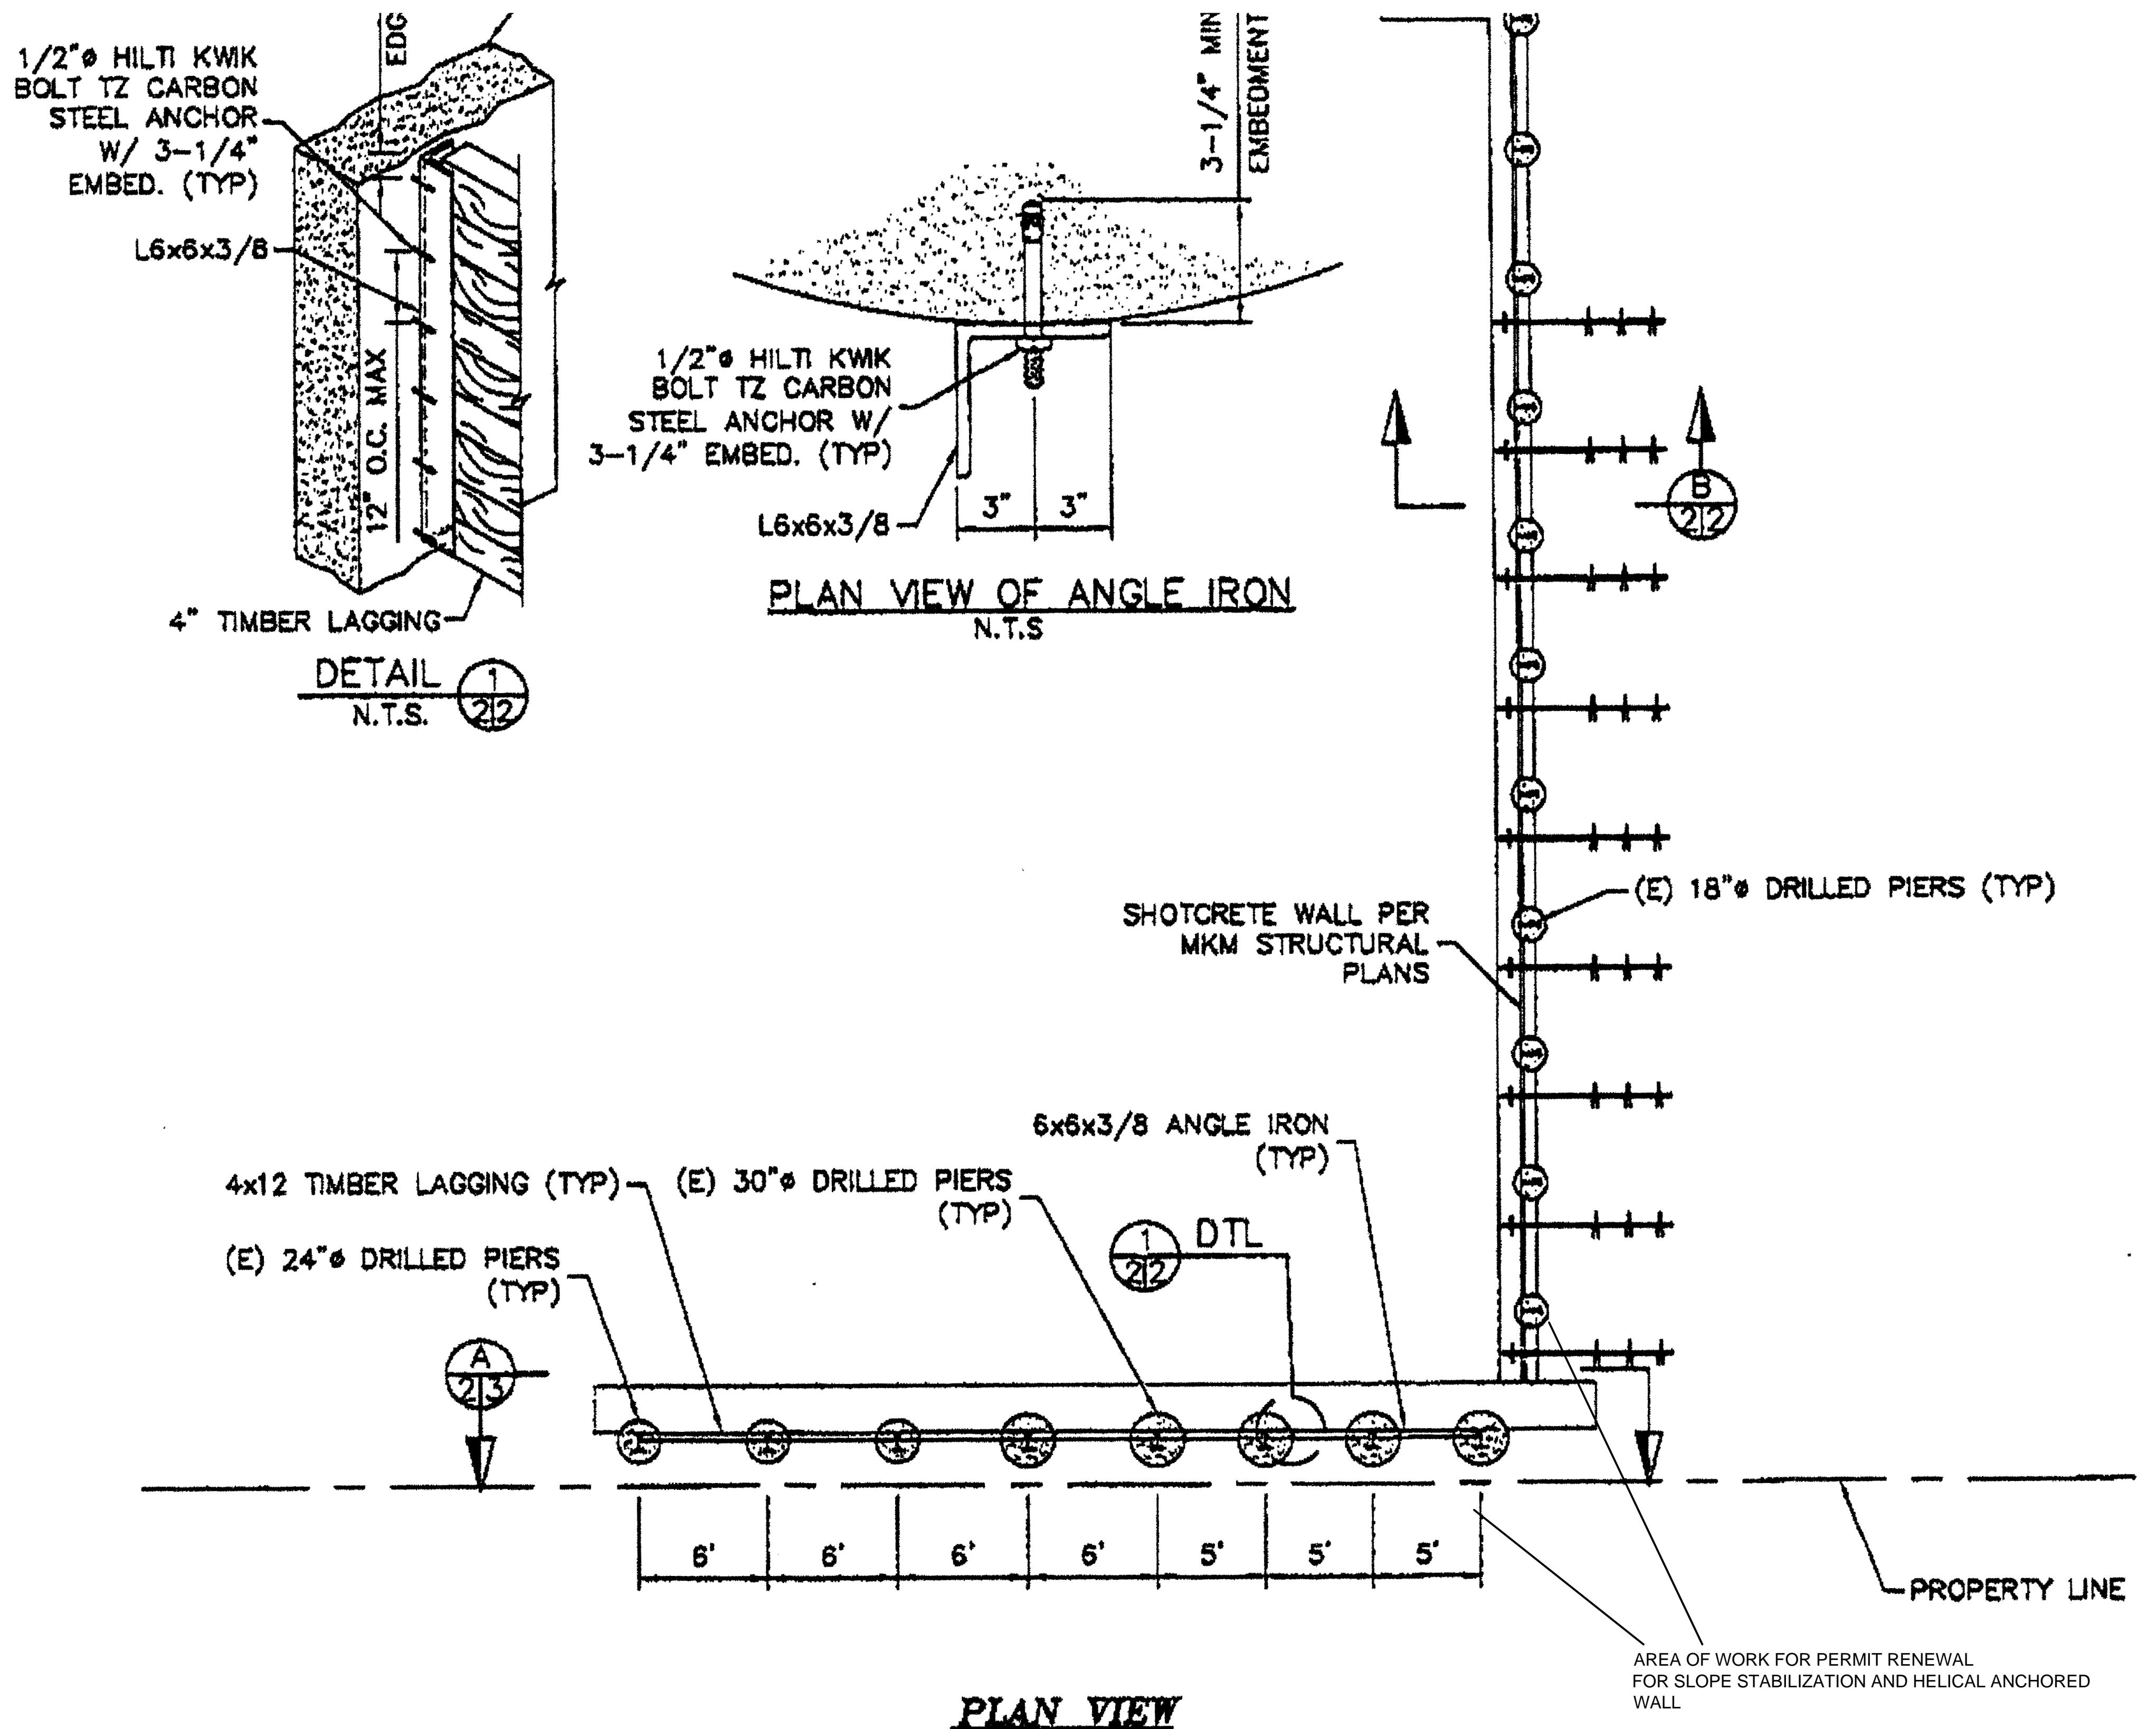

**NOTE: WARRANTY OF EXISTING CONSTRUCTION IS
NOT INCLUDED IN SCOPE OF WORK**

EL 500'-0"

CAP BEAM, WHALERS,
AND SHOTCRETE TO BE
COMPLETED UNDER
FOUNDATION PERMIT

SHOTCRETE REINFORCEMENT
PER MKM & ASSOCIATES
STRUCTURAL PLANS

MIRADRAIN & DRAIN PIPE PER
MKM & ASSOCIATES
STRUCTURAL PLANS

(E) HELICAL ANCHOR

EL 480'-11"

SECTION 
N.T.S.

0 5' 10'
SCALE: 1" = 10'-0"

S2/2