


Mar. 28, 2014 - 7:06am Z:\Year 2011 Jobs\2011-09-3 - Community Bldg\old drawings\ARCHITECTURE\A2.21-A2.26 REVISED 3-26-2014.dwg

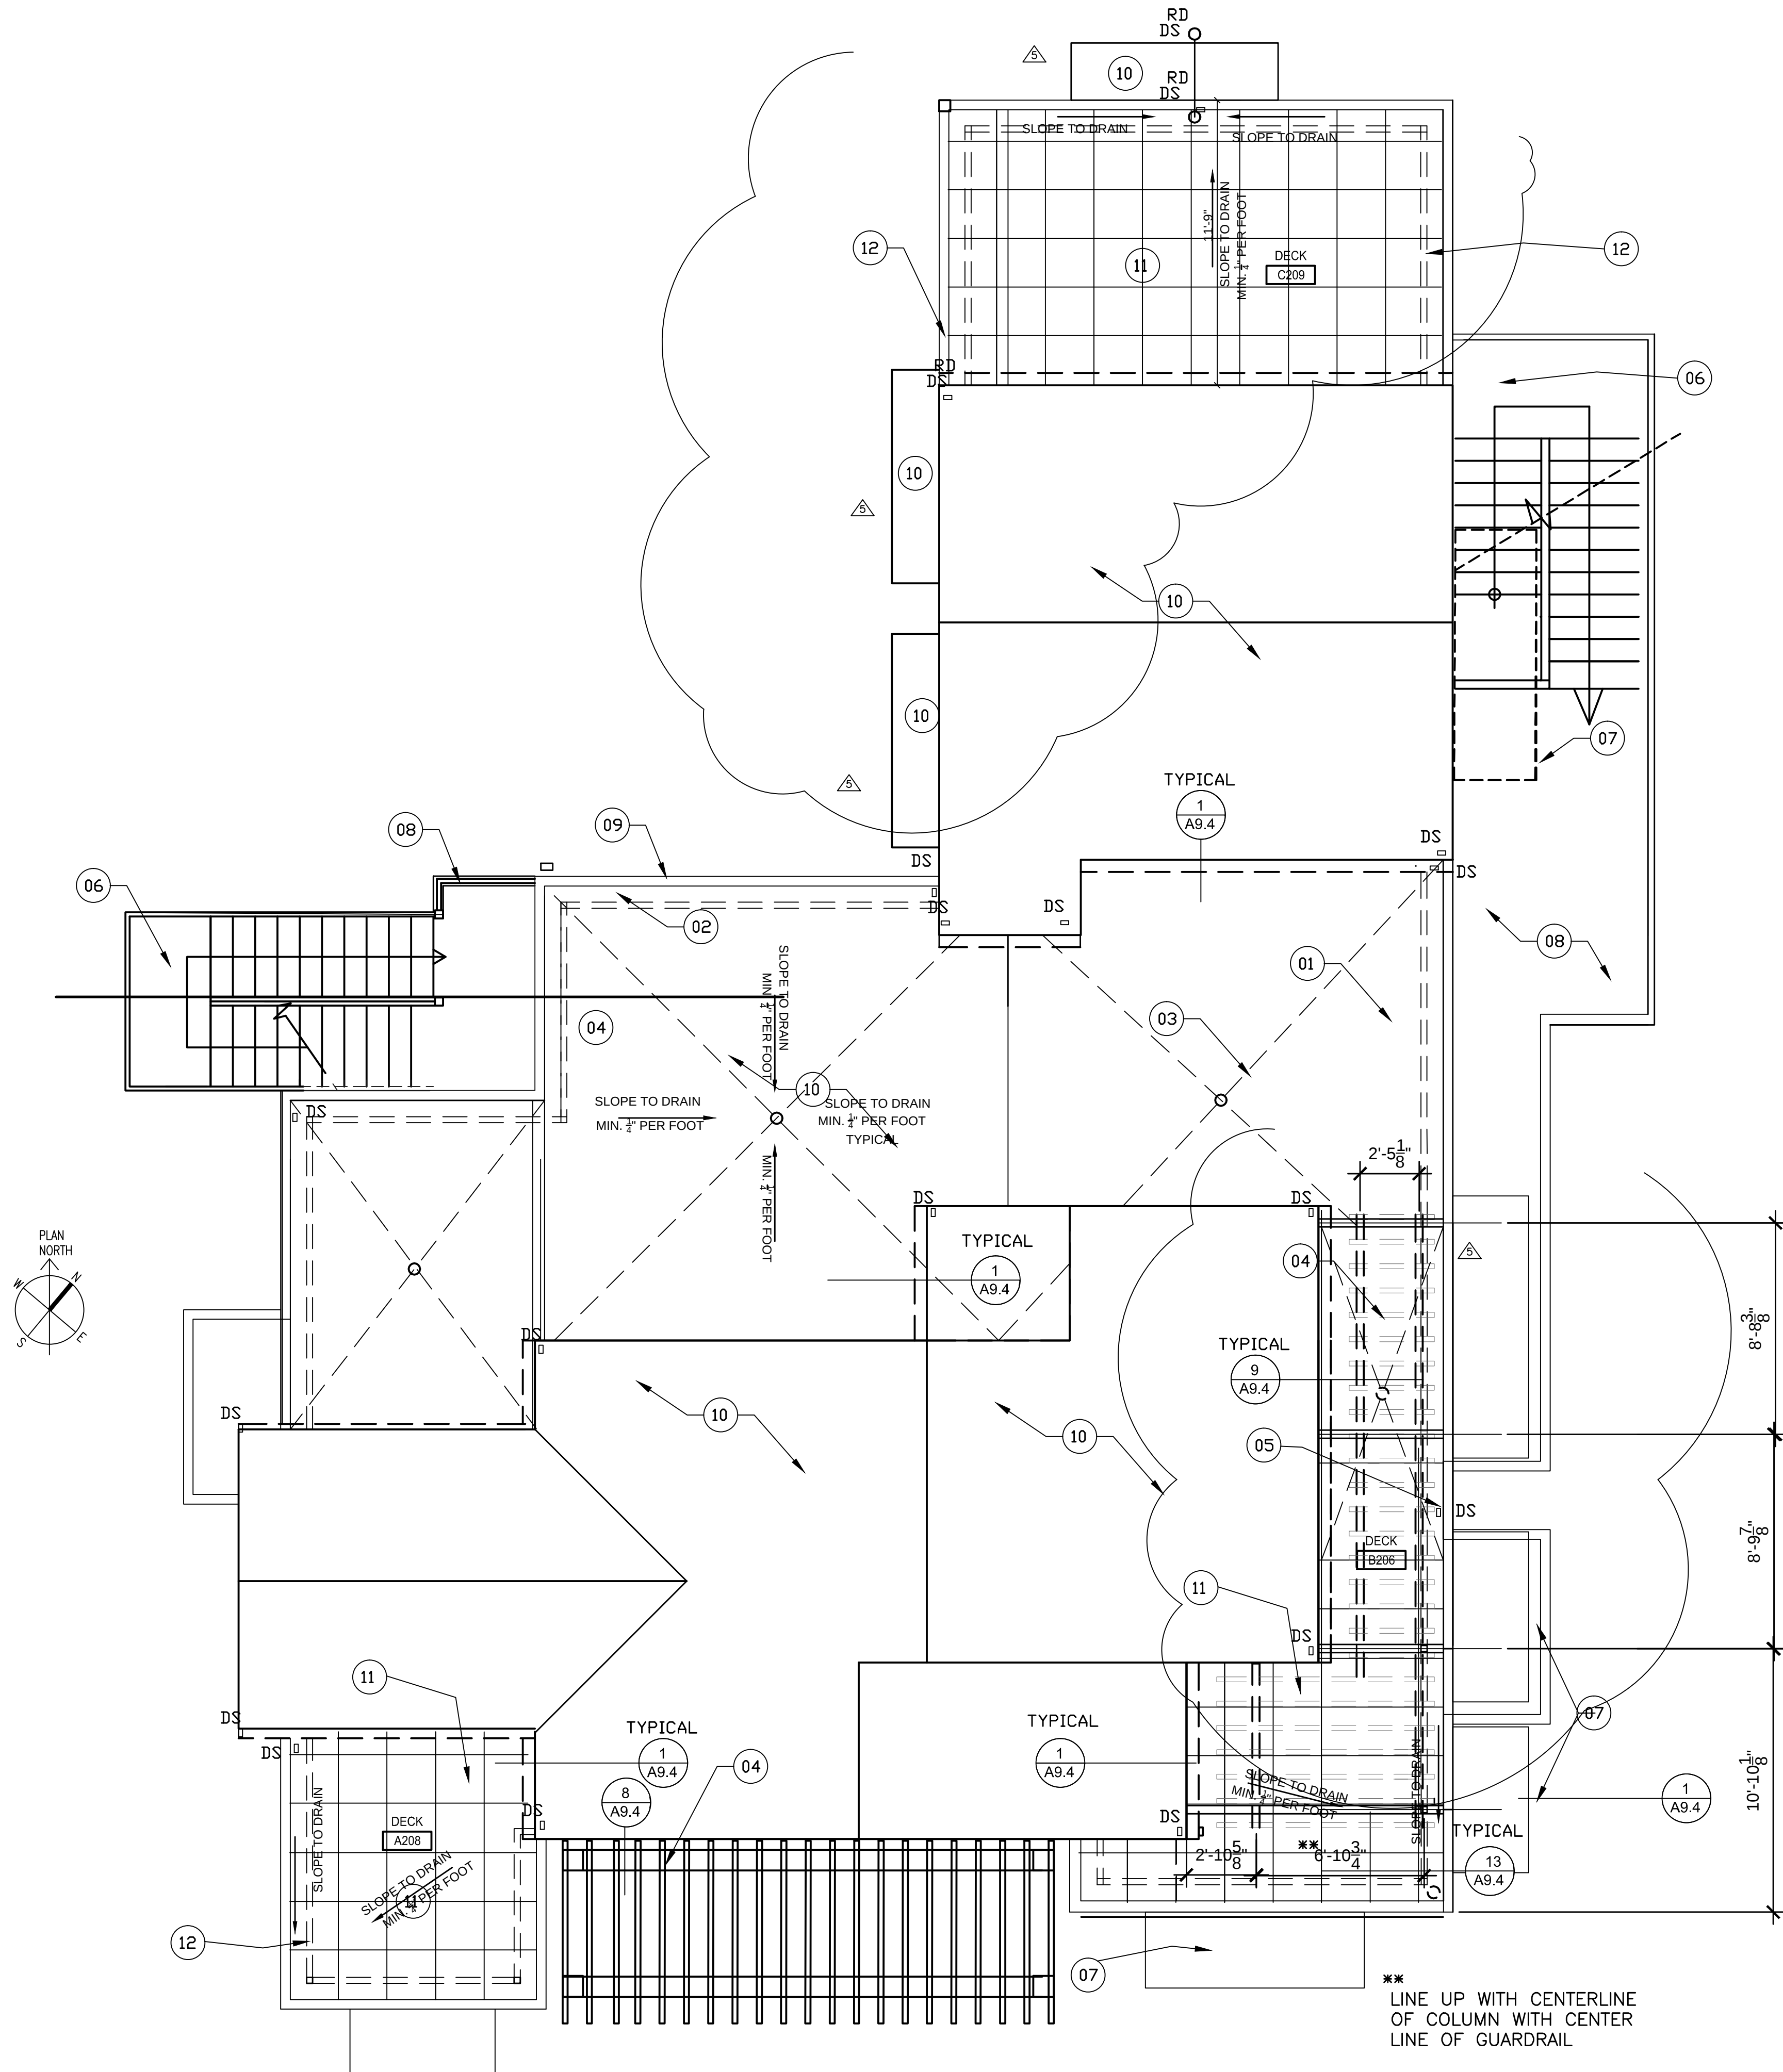

01

COMMUNITY CENTER ROOF PLAN

GENERAL NOTES

- ALL DIMENSIONS ARE TO FACE OF STUD OR CENTERLINE OF PARTITION WALL, INTERIOR COLUMN/ WINDOW/ DOOR UNLESS OTHERWISE NOTED.
- DETAILS ARE KEYED AND NOTED "TYPICAL" ONLY ONCE ON THE PLANS WHEN THEY FIRST OCCUR, AND ARE REPRESENTATIVE OF SIMILAR CONDITIONS THROUGHOUT, UNLESS OTHERWISE NOTED.
- FOR DOOR AND WINDOW KEYS REFER TO DOOR AND WINDOW SCHEDULE.


LEGEND

- ONE HOUR RATED WALL
- INTERIOR FULL HT. PARTITION
- INTERIOR BEARING PARTITION WALL
- EPS TRIM - MOLDING

KEYNOTES ROOF PLAN

- BEAM AT ROOF TRELLIS.
- ROOF LINE OF PARAPET.
- BUILT UP ROOF WITH 90 LB. CAP SHEET
- CLASS B ROOF SYSTEM. PROVIDE MIN. 1/4" SLOPE @ VALLEY
- TRELLIS W/ WOOD FRAME WITH STEEL POSTS
- THROUGH WALL SCUPPER AND 3X4 DOWN SPOUT. TERMINATE AT DOWNSPOUT AT SPLASH BLOCK.
- EXTERIOR STAIRS BELOW
- FABRIC AWNING BELOW.
- DECKING BELOW.
- CORNICE AT EDGE OF PARAPET.
- ASPHALT SHINGLE ROOF
- ROOF DECK
- METAL RAIL
- CHAIR LIFT

REVISIONS	BY
9/26/2011 - PLAN CHECK	G.O.
1/09/2014	STF
GUARDRAIL REVISED	
1/09/2014	
REVISED ROOF DRAINAGE	
1-10-2014	
REVISED ROOF DRAINAGE, WINDOWS AT HALLWAY	
1-26-2014	
ADDED ENLARGED PLAN SHEET	
3-27-2014	
ADDED ADA UNIT, SHORTENED TRELLIS	

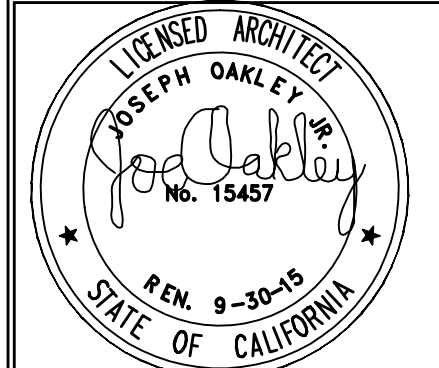

OAKLEY & OAKLEY
ARCHITECTS
7000 EDGEMONT DRIVE, SUITE 615
OAKLAND, CA 94621
TEL: 510.562.6043
FAX: 510.562.6043

PROJECT TITLE:
COMMUNITY CENTER
HARBOR PARK APARTMENTS
969 PORTER STREET, VALLEJO, CA 94580
DRAWING TITLE:
ENLARGED ROOF PLAN

Date:	04/10/2012
Scale:	3/16" = 1'-0"
Drawn:	STAFF
Checked:	RY
Job No.:	2011-09

Sheet:
A2.26
Of Sheets