


## 01 WINDOW SCHEDULE

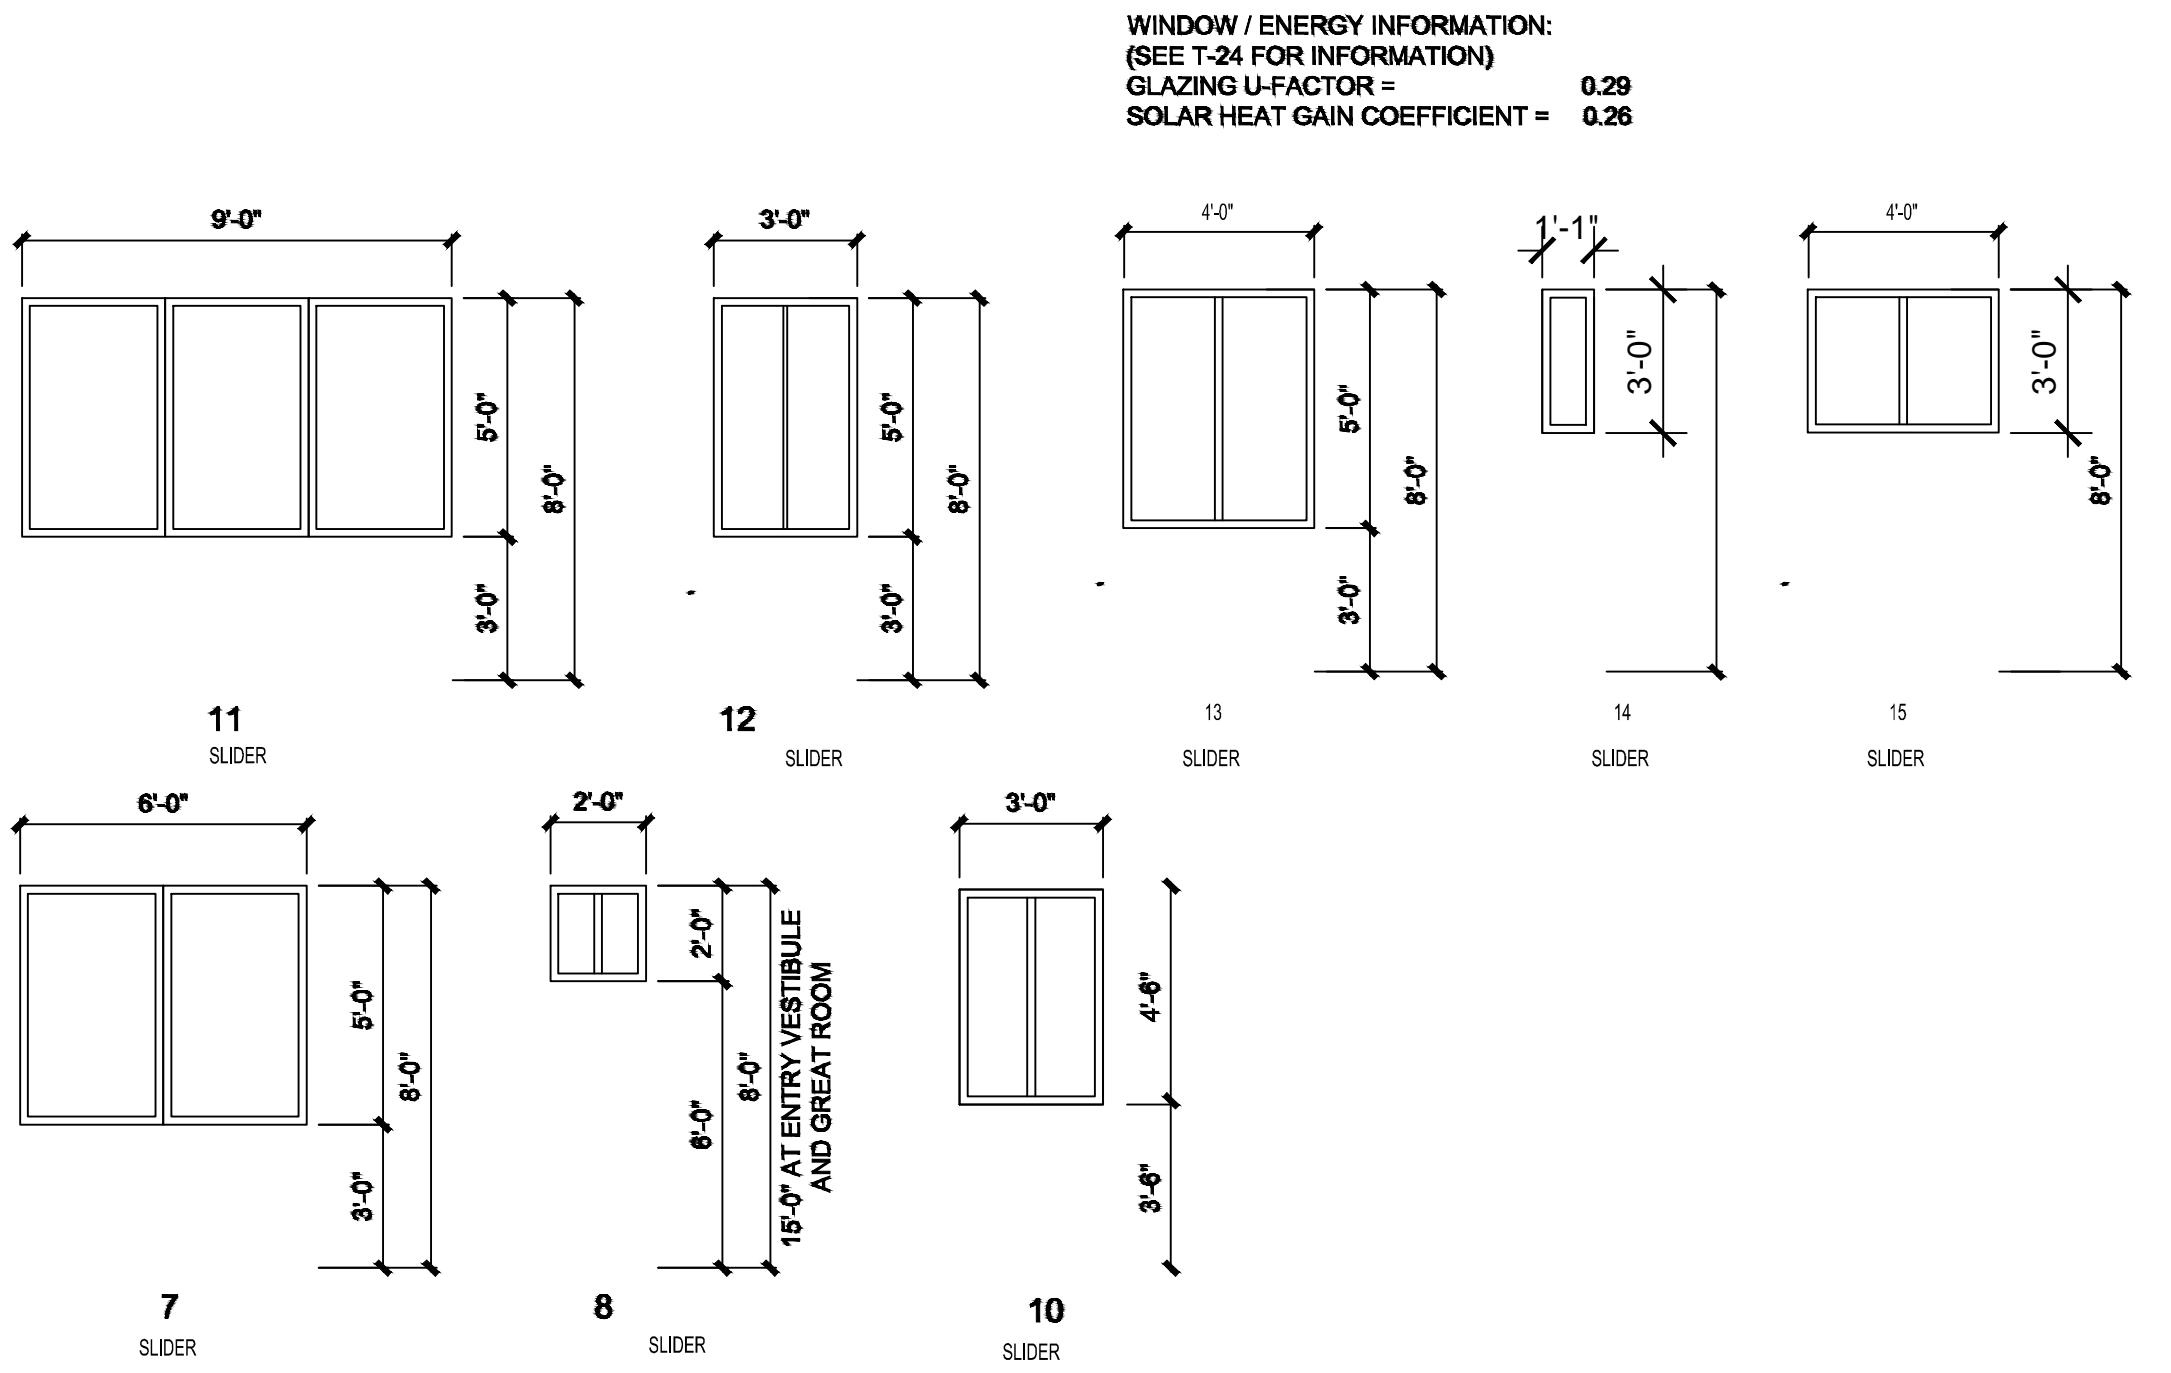

## 04 WINDOW TYPES

WINDOW MARK	WINDOW TYPE	SIZE	DETAILS						RATING	REMARKS
			SINGLE	DOUBLE	TEMP	LOWE	HEAD	JAMB		
G	7	6'-0" x 5'-0"			VINYL	X	X	10/CD1	10/CD1	22/CD1
M	11	8'-0" x 5'-0"			VINYL	X	X	10/CD1	10/CD1	22/CD1
N	12	3'-0" x 5'-0"			VINYL	X	X	10/CD1	10/CD1	22/CD1
O	7	6'-0" x 5'-0"			VINYL	X	X	10/CD1	10/CD1	16/CD1
P	7	3'-0" x 8'-0"			ALUM	X	X	10/CD1	10/CD1	16/CD1
O	13	4'-0" x 5'-0"			VINYL	X	X	10/CD1	10/CD1	22/CD1
R	14	1'-0" x 5'-0"			VINYL	X	X	10/CD1	10/CD1	22/CD1
S	15	4'-0" x 3'-0"			VINYL	X	X	10/CD1	10/CD1	22/CD1

## 05 WINDOW SCHED. SYMBOL


## WINDOW NOTES:

INSTALL DEVICES WHICH ALLOW WINDOWSTO BE LOCKED FROMINTERIOR  
ALL WINDOWS SHALL BE DUAL GLAZED WITH WEATHER-STRIPPED  
INFILTRATION FRAMES MEETING ANSI AIR INFILTRATION STANDARDS.

SAFETY GLAZING SHALL BE INSTALLED IN THE FOLLOWING  
LOCATIONS: PER (2010CBC 2406.3)

1. GLAZING IN SWINGING DOORS EXCEPT JALOUSIES
2. GLAZING IN FIXED AND SLIDING PANELS OF SLIDING  
DOOR ASSEMBLIES AND PANELS IN SLIDING AND  
BI-FOLD CLOSET DOOR ASSEMBLIES
3. GLAZING IN STORM DOORS
4. GLAZING IN UNFRAMED SWINGING DOORS
5. GLAZING IN DOORS AND ENCLOSURES FOR HOT TUBS,  
WHIRLPOOLS, SAUNAS, STEAM ROOMS, BATHTUBS AND  
SHOWERS. GLAZING IN ANY PORTION OF A BUILDING  
WALL ENCLOSING THESE COMPARTMENTS WHERE THE  
BOTTOM EXPOSED EDGE OF GLAZING IS LESS THAN  
60" ABOVE A STANDING SURFACE.
6. GLAZING IN INDIVIDUAL FIXED OR OPERABLE PANEL  
ADJACENT TO A DOOR WHERE THE NEAREST EXPOSED  
EDGE OF THE GLAZING IS WITHIN A 24" ARC OF EITHER  
VERTICAL EDGE OF THE DOOR IN A CLOSED POSITION  
AND WHERE THE BOTTOM EXPOSED EDGE OF GLAZING IS  
LESS THAN 60" ABOVE THE WALKING SURFACE.

EXCEPTION:  
AN INTERVENING WALL BETWEEN DOOR & GLAZING

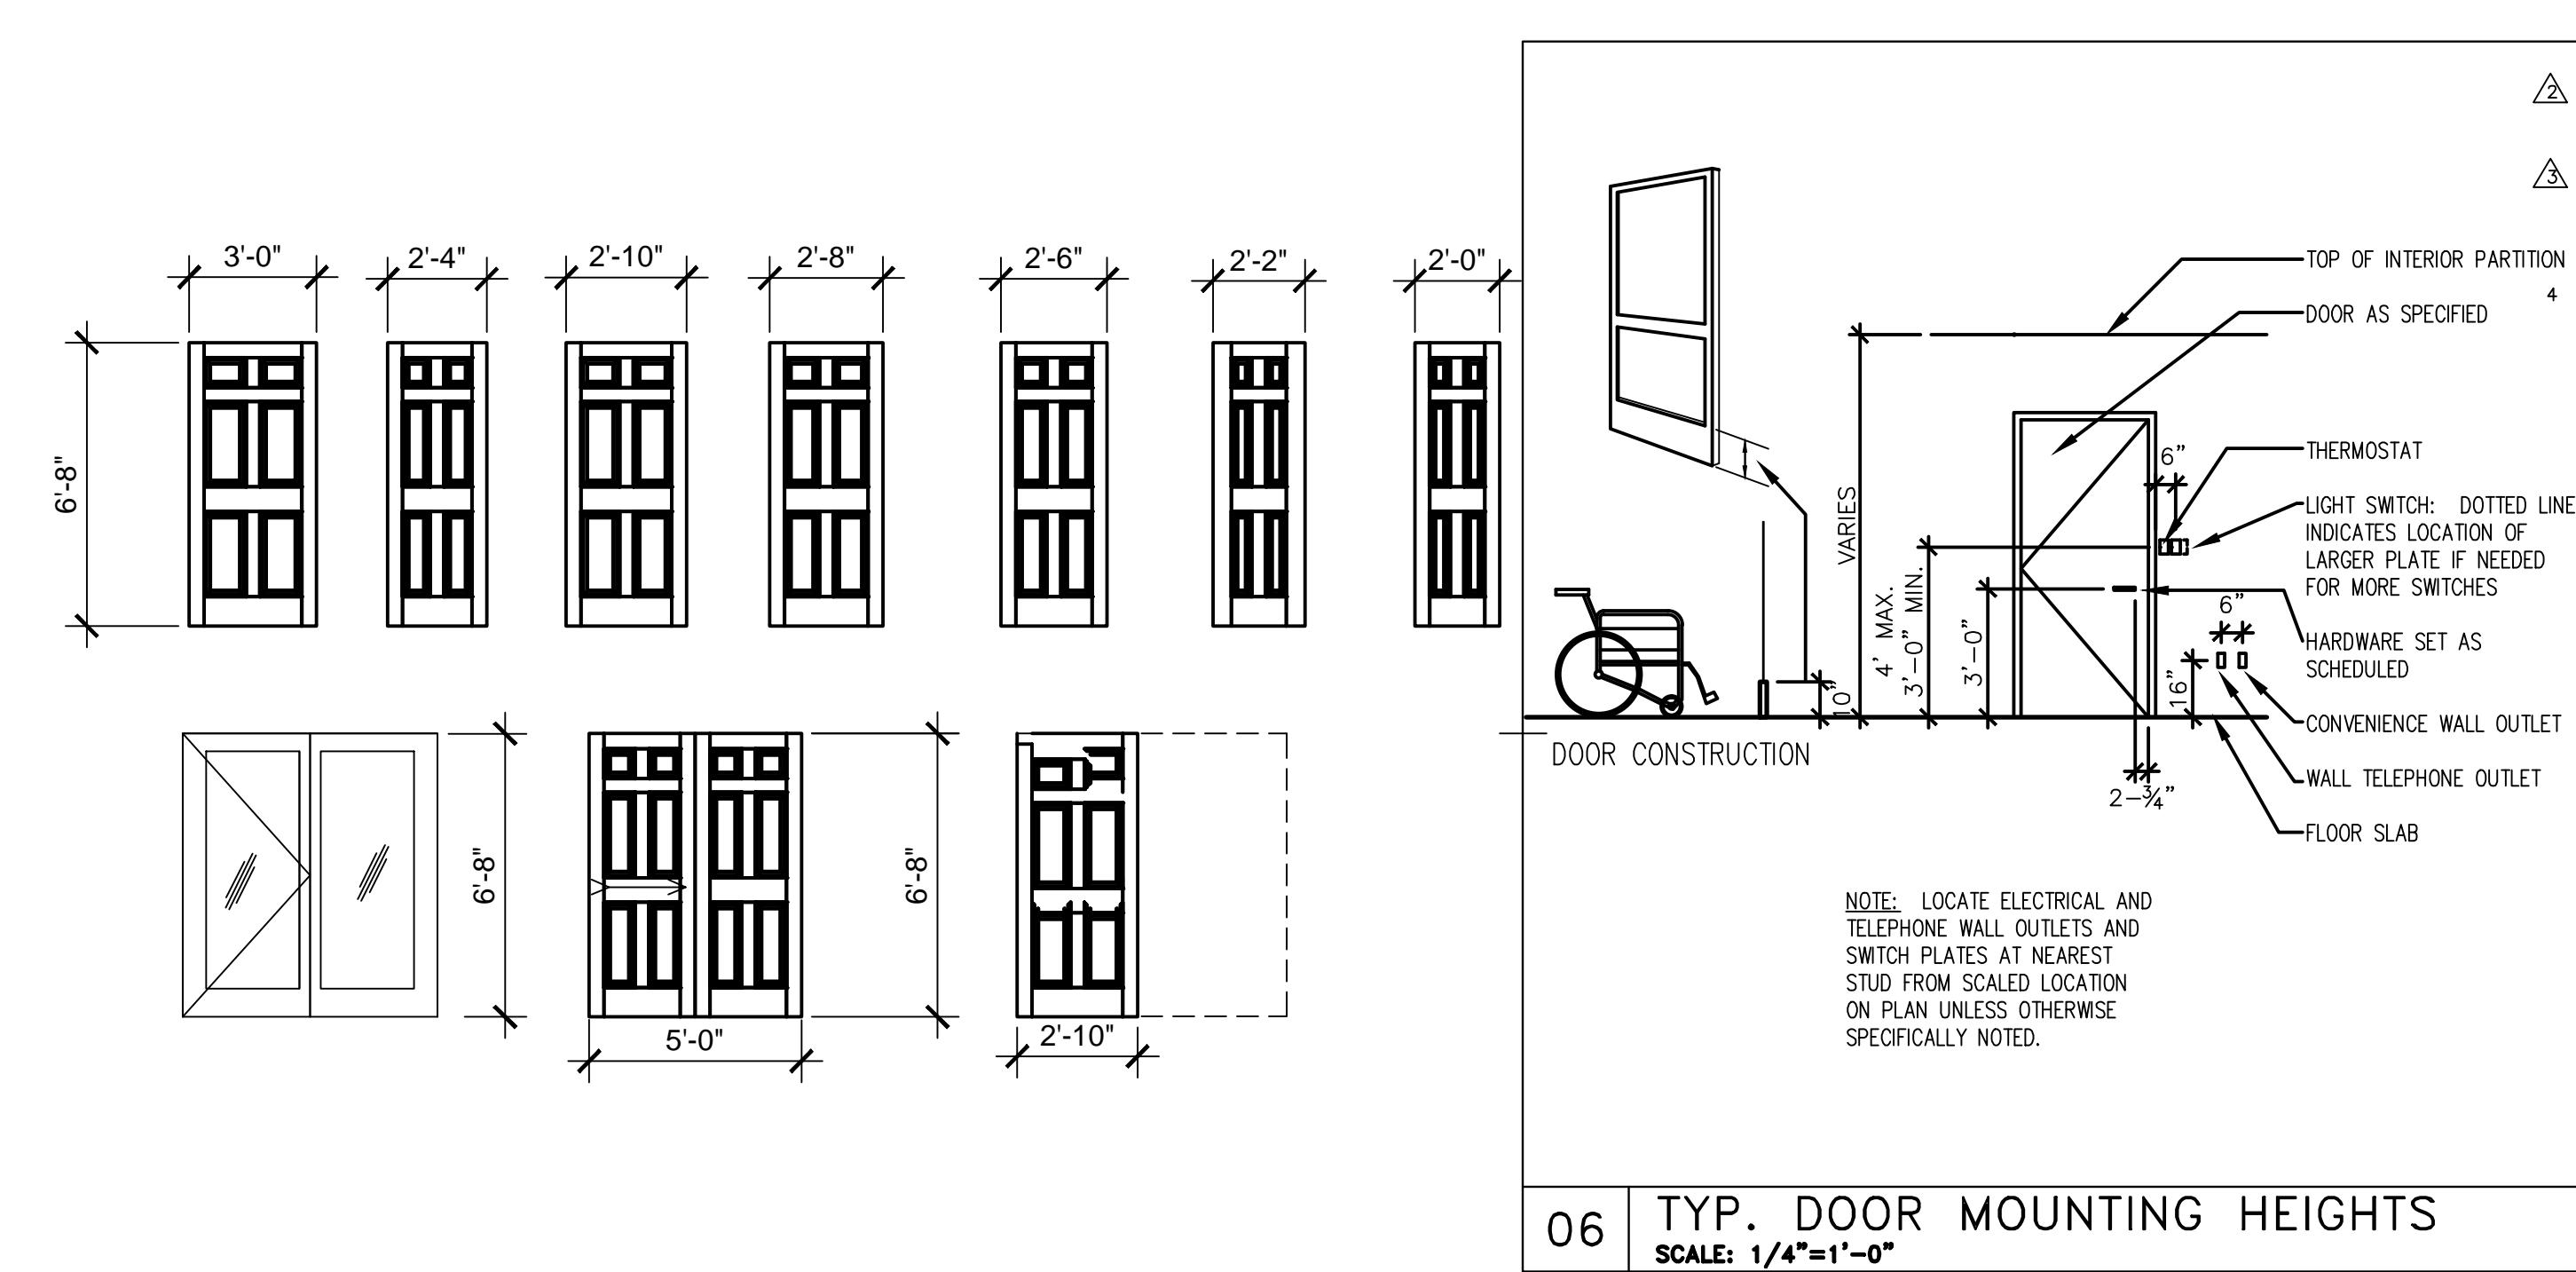

REVISIONS	BY
9/26/2011 - PLAN CHECK	G.O.
01/18/2014	JO/LR
BIDDING	
01/26/2014	JO
BIDDING	
03/27/2014 - DOOR SCHEDULE	STAFF

*JOSEPH OAKLEY*  
LICENSED ARCHITECT  
No. 15457  
RE. 9-30-14  
STATE OF CALIFORNIA

**OAKLEY & OAKLEY**  
ARCHITECTS CIVIL & STRUCTURAL ENGINEERS  
7400 E. GEDWEYER DRIVE, SUITE 615  
FAX 510-562-6028  
300-562-6043

PROJECT TITLE:  
COMMUNITY CENTER  
HARBOR PARK APARTMENTS  
969 PORTER STREET, VALLEJO, CA 94560  
DRAWING TITLE:  
RESIDENTIAL UNITS A,B,C,D  
DOOR & WINDOW SCHEDULE

Date: 04/17/2012  
Scale: AS NOTED  
Drawn: STAFF  
Checked: RY  
Job No.: 2011-09  
Sheet: A9.1  
of Sheets